



Page 1 of 3 in order 170143 File number: 1730122-07653 Completed: 9/12/2022 Surveyed: 9/8/2022

Client: SUNBELT TITLE CORAL GABLES Lender: ANCHOR NATIONWIDE LOANS, LLC

Buyer: JONATHON MAX ALBERT

Seller: VALLI D. ELLIOTT, SURVIVING TRUSTEE OF THE

DOLLY PHILLIPS ELLIOTT LIVING TRUST

Premises: 1180 NE 102ND STREET, MIAMI SHORES, FLORIDA 33138 MIAMI-DADE



CERTIFIED TO: SUNBELT TITLE AGENCY, ANCHOR NATIONWIDE LOANS, LLC, JONATHON MAX ALBERT, TITLE RESOURCES GUARANTY COMPANY

TRUELINE TECHNOLOGIES LLC: THE FOLLOWING PRODUCT HAS BEEN COMPLETED BY THE STATE LICENSED LAND SURVEYING FIRM AS INDICATED ON THE FOLLOWING PAGE. TRUELINE TECHNOLOGIES LLC PROVIDES THE DIGITAL TRANSMISSION AND ARCHIVING OF THE PRODUCT, AND IS NOT INVOLVED IN ANY FACET OF THE TECHNICAL FIELD WORK PERFORMED AND MAKES NO WARRANTIES AS TO THE ACCURACY OF SUCH WORK. ALL TRANSMISSIONS OF THE PRODUCT ARE VIA A SECURE 'SHA-1' SECURE HASH MESSAGE DIGEST AUTHENTICATION CODE WITHIN ITS SIGNATURE FILE: A MANUALLY SIGNED AND SEALED LOG OF THIS SURVEY'S SIGNATURE FILE IS KEPT ON FILE AT THE PERFORMING SURVEYORS OFFICE.

PRINTING PROCEDURES: BECAUSE THIS FILE HAS BEEN SENT ELECTRONICALLY, IT IS IMPERATIVE THAT THE PRINT SETTINGS BE CORRECT IN ORDER TO DEPICT AN ACCURATE REPRESENTATION OF THIS DOCUMENT ON PAPER. INSTRUCTIONS: WHILE VIEWING THE PRODUCT IN ADOBE READER, SELECT PRINT UNDER THE FILE TAB. SELECT COLOR PRINTER. UNDER PRINT RANGE - SELECT ALL. UNDER PAGE HANDLING, SELECT NONE FOR PAGE SCALING AND UNCHECK AUTO ROTATE AND CENTER. CHOOSE PAPER SOURCE BY PDF SIZE. CLICK PRINT.




www.exactaland.com | office: 866.735.1916 | fax: 866.744.2882



PROPERTY ADDRESS: 1180 NE 102ND STREET, MIAMI SHORES, FLORIDA 33138

2209.0876 **BOUNDARY SURVEY** MIAMI-DADE COUNTY

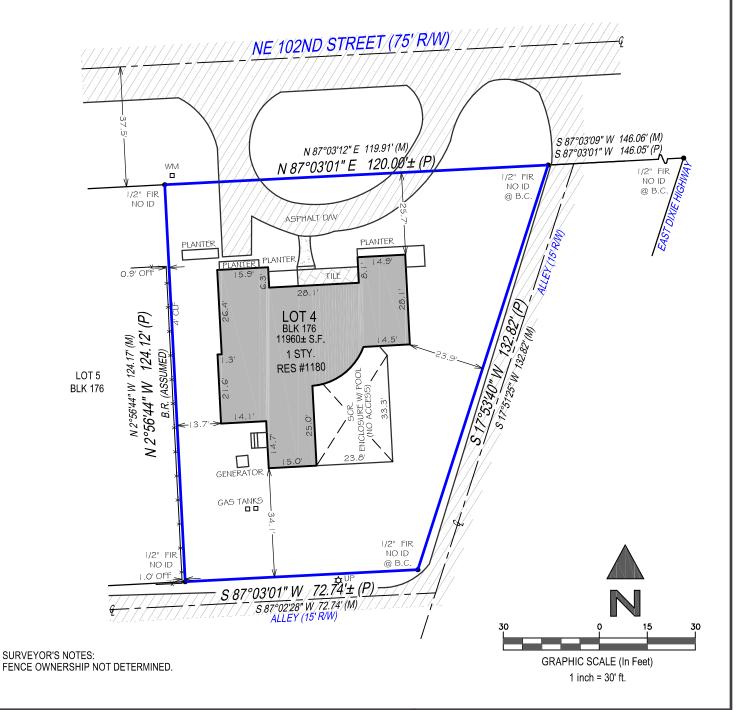



Exacta Land Surveyors, LLC | LB# 8291

SURVEYORS CERTIFICATION:

I hereby certify that this Survey of the lands described hereon was made under my direct supervision, and to the best of my knowledge and belief is a true and accurate representation of said lands and meets the Standards of Practice set forth in Chapter 5J-15.050 through 5J -15.053, Florida Administrative Code, pursuant to section 472.027, Florida Statutes. This survey is not valid without the signature and original raised seal of a Florida licensed surveyor and mapper, except when the electronic signature and seal of a Florida licensed surveyor and mapper is affixed hereto.

POINTS OF INTEREST:

NONE VISIBLE





P 866-772-8813 F 215-359-1733 www.truelinetech.com

DATE SIGNED: 09/12/22 **FIELD WORK DATE: 9/8/2022**

SEE PAGE 2 OF 2 FOR LEGAL DESCRIPTION PAGE 1 OF 2 - NOT VALID WITHOUT ALL PAGES

REVISION DATE(S): (REV.0 9/12/2022)

JOB SPECIFIC SURVEYOR NOTES:

THE ASSUMED BEARING REFERENCE OF NORTH 2 DEGREES 56 MINUTES 44 SECONDS WEST IS BASED ON THE WESTERLY PROPERTY LINE OF LOT 4, BLOCK 176, LOCATED WITHIN REVISED PLAT OF TRACTS 175A, 175B, 175C, 176A, 176B, 176C, 177A, 177B AND 178A OF THE REVISED PLAT OF MIAMI SHORES, SECTION 8, ACCORDING TO THE PLAT THEREOF, AS RECORDED IN PLAT BOOK 43, PAGE 67 OF THE PUBLIC RECORDS OF MIAMIDADE COUNTY, FLORIDA.

LEGAL DESCRIPTION:

LOT 4, IN BLOCK 176, OF REVISED PLAT OF TRACTS 175A, 175B, 175C, 176A, 176B, 176C, 177A, 177B AND 178A OF THE REVISED PLAT OF MIAMI SHORES, SECTION 8, ACCORDING TO THE PLAT THEREOF, AS RECORDED IN PLAT BOOK 43, AT PAGE 67, OF THE PUBLIC RECORDS OF MIAMIDADE COUNTY, FLORIDA.

GENERAL SURVEYOR NOTES:

- The Legal Description used to perform this survey was supplied by others. This survey does not determine nor imply ownership of the lands or any fences shown hereon. Unless the Title Commitment Number is referenced on this survey, an examination of the abstract of title was NOT performed by the signing surveyor to determine which instruments, if any, are affecting this property. property.
- The purpose of this survey is to establish the boundary of the lands described by the legal description provided and to depict the visible improvements thereon for a pending financial transaction. Underground footings, utilities, or 2. other service lines, including roof eave overhangs were not located as part of this survey. Unless specifically stated otherwise the purpose and intent of this survey is not for any construction activities or future planning.
- If there is a septic tank or drain field shown on this survey. In the location depicted hereon was either shown to the surveyor by a third party or it was estimated by visual above ground inspection. No excavation was performed to determine its location.
- This survey is exclusively for a pending financial transaction and only to be used by the parties to whom it is certified.

- Alterations to this survey map and report by other than the signing surveyor are prohibited.
- 6. Dimensions are in feet and decimals thereof.
- Any FEMA flood zone data contained on this survey is for informational purposes only. Research to obtain said data was performed at www.fema.gov and may not reflect the most recent information.
- Unless otherwise noted "SIRC" indicates a Set Iron Rebar with a Cap stamped LB#8291, a minimum half inch in diameter and eighteen inches long.
- If you are reading this survey in an electronic format, the information contained on this document is only valid if this document is electronically signed as specified in Chapter 5J17.062 (3) of the Florida Administrative Code and Florida Statute 472.025. The Electronic Signature File related to this document is prominently displayed on the invoice for this survey which is sent under separate cover. Manually signed and sealed logs of all survey signature files are kept in the office of the performing surveyor.
- The symbols reflected in the legend and on this survey may have been enlarged or reduced for clarity. The symbols have been plotted at the approximate center of

the field location and may not represent the actual shape or size of the feature.

SURVEY NUMBER: 2209.0876

- Points of Interest (POI's) are select above-ground improvements, which may appear in conflict with boundary, building setback or easement lines, as defined by the parameters of this survey. These POI's may not represent all items of interest to the viewer. There may be additional POI's which are not shown or called-out as POI's, or which are otherwise unknown to the surveyor
- Utilities shown on the subject property may or may not indicate the existence of recorded or unrecorded utility easements.
- performed exclusively by and is the sole responsibility of Exacta Land Surveyors, LLC. Additional logos or references to third party firms are for informational purposes only.
- Pursuant to F.S. 558.0035, an individual employee or agent may not be held individually liable for negligence.
- Due to varying construction standards, building dimensions are approximate and are not intended to be used for new construction or planning.

SURVEYOR'S LEGEND

LINETYPES	
	Boundary Line
	Center Line
* * * * *	Chain Link or Wire Fence
	Easement
	Edge of Water
-00-	Iron Fence
—OHL—	Overhead Lines
	Structure
	Survey Tie Line
-0000-	Vinyl Fence
	Wall or Party Wall
" "	Wood Fence
SURFACE TYPES	
	Asphalt
ZZZ	Brick or Tile
	Concrete
)><[Covered Area
	Water
\	Wood
SYMBOLS	
A	
4	Benchmark
Q Q	Benchmark Center Line
\mathcal{L}	
\mathcal{L}	Center Line Central Angle or
	Center Line Central Angle or Delta Common
	Center Line Central Angle or Delta Common Ownership

A. Co	Elevation
7	Fire Hydrant
•	Find or Set Monument
\leftarrow	Guywire or Anchor
4	Manhole
€	Tree
*	Utility or Light Pole
(W)	Well

ABBREVIATIONS (C) - Calculated

(**D**) - Deed (F) - Field

(M) - Measured

(**P**) - Plat (R) - Record

(S) - Survey

A/C - Air Conditioning

AE - Access Easement

ANE - Anchor Easement

ASBL - Accessory Setback Line B/W - Bay/Box Window

BC - Block Corner

BFP - Backflow Preventer

BLDG - Building

BLK - Block

BM - Benchmark

BR - Bearing Reference **BRL** - Building Restriction Line

BSMT - Basement

C - Curve

C/L - Center Line

C/P - Covered Porch C/S - Concrete Slab

CATV - Cable TV Riser CB - Concrete Block

CH - Chord Bearing

CHIM - Chimney CLF - Chain Link Fence

CME - Canal Maintenance

co - Clean Out

COR - Corner CS/W - Concrete Sidewalk

CUE - Control Utility Easement

CVG - Concrete Valley Gutter

D/W - Driveway

DE - Drainage Easement

DF - Drain Field

DH - Drill Hole

DUE - Drainage & Utility

ELEV - Elevation

EM - Electric Meter

ENCL - Enclosure

ENT - Entrance

EOP - Edge of Pavement EOW - Edge of Water

ESMT - Easement

EUB - Electric Utility Box F/DH - Found Drill Hole

FCM - Found Concrete

CLIENT FILE NO: 170143

FF - Finished Floor

FIP - Found Iron Pipe FIPC - Found Iron Pipe & Cap FIR - Found Iron Rod

FIRC - Found Iron Rod & Cap

FN - Found Nail

FN&D - Found Nail & Disc

FRRSPK - Found Rail Road

GAR - Garage

GM - Gas Meter

ID - Identification IE/EE - Ingress/Egress Easement

ILL - Illegible

INST - Instrument INT - Intersection

IRRE - Irrigation Easement

L - Length

LAE - Limited Access Easement

LB# - License No. (Business)

LBE - Limited Buffer Easement

LE - Landscape Easement LME - Lake/Landscape

Maintenance Easer

LS# - License No. (Surveyor)

MB - Map Book

ME - Maintenance Easement MES - Mitered End Section

MF - Metal Fence

MH - Manhole

MHWL - Mean High Water Line

NR - Non-Radial

NTS - Not to Scale

NAVD88 - North American Vertical Datum 1988

NGVD29 - National Geodetic Vertical Datum 1929

OG - On Ground

ORB - Official Records Book **ORV** - Official Record Volume

O/A - Overall

O/S - Offset

OFF - Outside Subject Property

OH - Overhang

OHL - Overhead Utility Lines

OHWL - Ordinary High Water

ON - Inside Subject Property

P/E - Pool Equipment

PB - Plat Book PC - Point of Curvature

PCC - Point of Compound

Curvature PCP - Permanent Control Point

PI - Point of Intersection

PLS - Professional Land Surveyor

PLT - Planter

POB - Point of Beginning

POC - Point of Commencement

PRC - Point of Reverse

PRM - Permanent Reference Monument

PSM - Professional Surveyor

& Mapper PT - Point of Tangency

PUE - Public Utility Easement

R - Radius or Radial R/W - Right of Way

RGE - Range

ROE - Roof Overhang Easement **RP -** Radius Point

S/W - Sidewalk SBL - Setback Line

SCL - Survey Closure Line

SCR - Screen SEC - Section

SEP - Septic Tank

SEW - Sewer

SIRC - Set Iron Rod & Cap SMWE - Storm Water

Management Easement

SN&D - Set Nail and Disc

SQFT - Square Feet

STL - Survey Tie Line

STY - Story SV - Sewer Valve

SWE - Sidewalk Easement

TBM - Temporary Bench Mark

TEL - Telephone Facilities

TOB - Top of Bank TUE - Technological Utility

TWP - Township

TX - Transformer

TYP - Typical

UE - Utility Easement

UG - Underground

UP - Utility Pole

UR - Utility Riser **VF -** Vinyl Fence

W/C - Witness Corner W/F - Water Filter

WF - Wood Fence WM - Water Meter/Valve Box WV - Water valve

CERTIFIED TO:

JONATHON MAX ALBERT ; SUNBELT TITLE AGENCY; TITLE RESOURCES GUARANTY COMPANY; ANCHOR NATIONWIDE LOANS, LLC

FLOOD ZONE INFORMATION: BY PERFORMING A SEARCH WITH THE LOCAL GOVERNING MUNICIPALITY OR WWW.FEMA.GOV, THE PROPERTY APPEARS TO BE LOCATED IN ZONE X & AE (WITH A BASE FLOOD ELEVATION OF 8). THIS PROPERTY WAS FOUND IN THE VILLAGE OF MIAMI SHORES,

DATE SIGNED: 09/12/22

COMMITMENT DATE:

BUYER: Jonathon Max Albert

LENDER: ANCHOR NATIONWIDE LOANS, LLC

TITLE COMPANY: SUNBELT TITLE AGENCY

SEE PAGE 1 OF 2 FOR MAP OF PROPERTY PAGE 2 OF 2 - NOT VALID WITHOUT ALL PAGES Land Surveyors, LLC

COMMUNITY NUMBER 120652, PANEL NUMBER 0306 DATED 09/11/2009.

Exacta Land Surveyors, LLC

o: 866.735.1916 | f: 866.744.2882 3846 Blanding Boulevard, Jacksonville, FL 32210